




Testimony of Srividhya Viswanathan, P.E.


South Coast Air Quality Management District Hearing

Case No. 6177-4

December 9 and 11, 2025

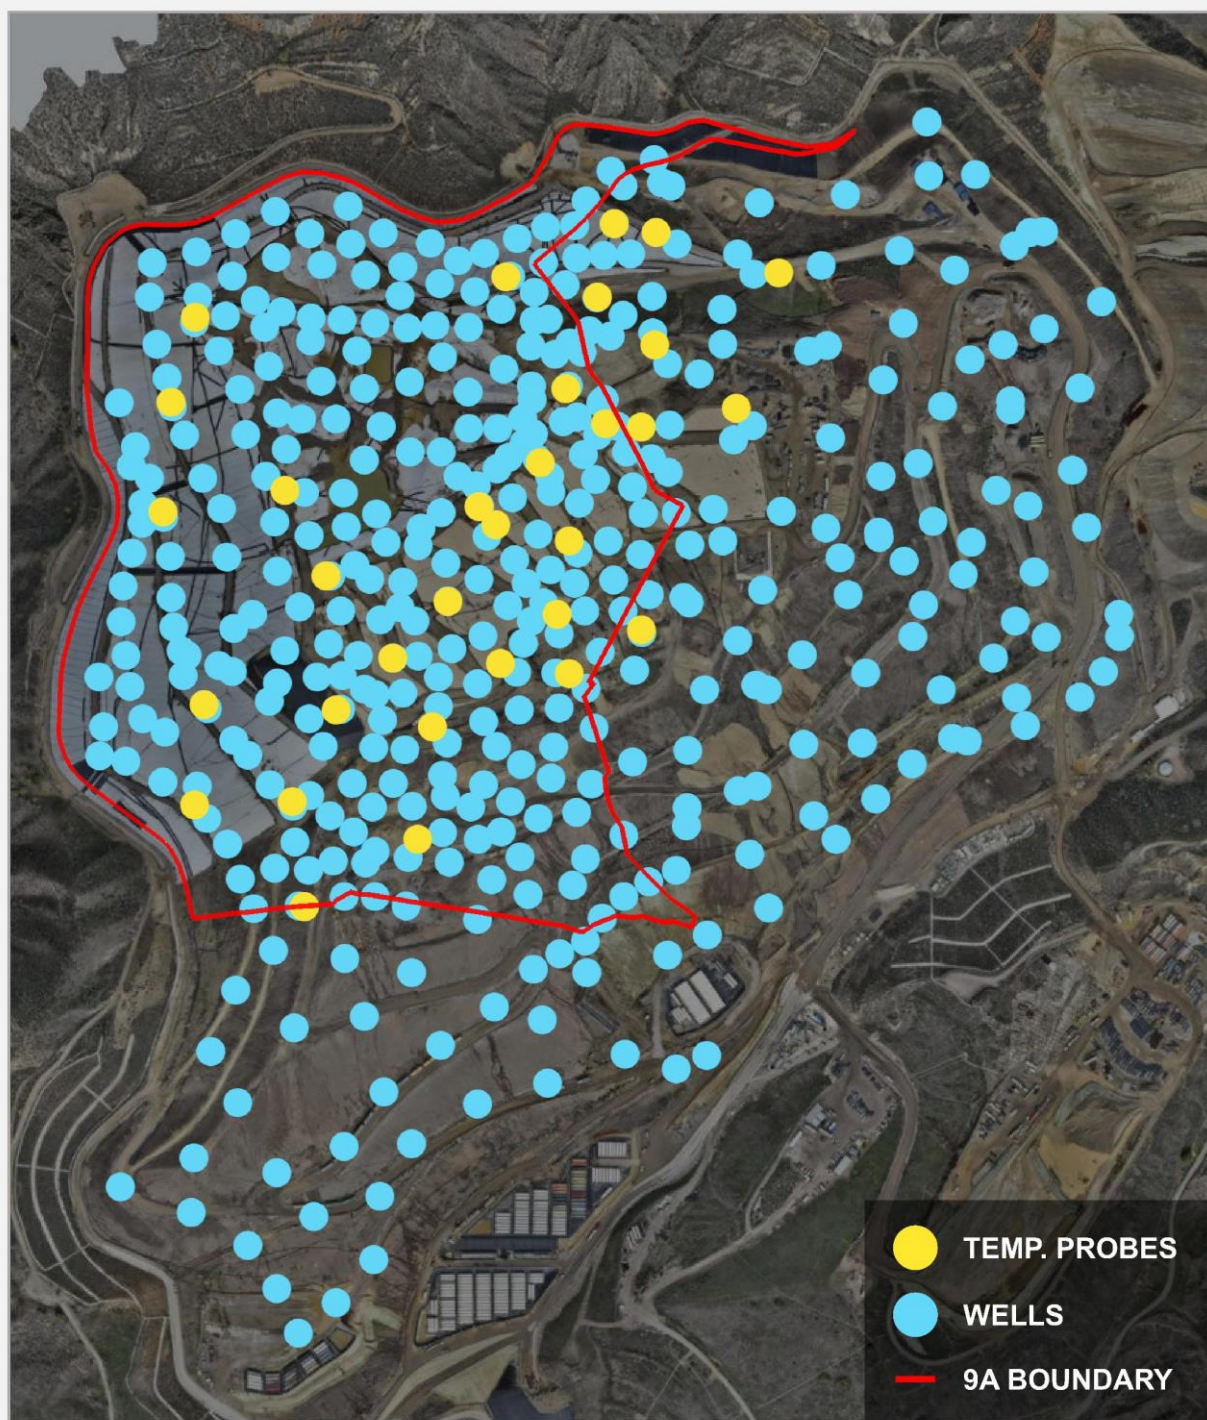

Tank Farm 13

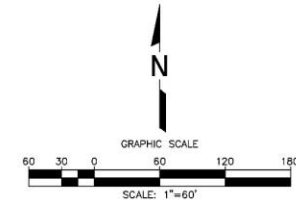

GENERAL DRAWING NOTES:

- EXISTING TOPOGRAPHIC SURVEY INFORMATION SHOWN WAS PROVIDED BY TETRA TECH. AERIAL PHOTOGRAPHY DATED OCTOBER 15, 2025.
- NORTH ARROW SHOWN HERE IS REFERENCE TO THE CALIFORNIA STATE PLANE ZONE V COORDINATE SYSTEM, NAD 83.

**AS-BUILT PROGRESS DRAWINGS
NOT ISSUED FOR FINAL RECORD**



CLIENT:
CHQUIITA CANYON LANDFILL
CASTAIC, CALIFORNIA

SCS ENGINEERS
ENVIRONMENTAL CONSULTANTS
10000 WILSON AVENUE
SUITE 200
DALLAS, TEXAS 75243
(972) 517-5000 FAX: (972) 427-0805
PROJECT NO. 01204123.41
DATE: 10/23/2025
SCALE: AS SHOWN
SHEET: 1

SHEET TITLE:
AS-BUILT TANK FARM SITE PLAN
PROJECT TITLE:
TANK FARM #13 PROJECT
CHQUIITA CANYON LANDFILL
CASTAIC, CALIFORNIA

NO.	REVISION	DATE
1		
2		
3		
